

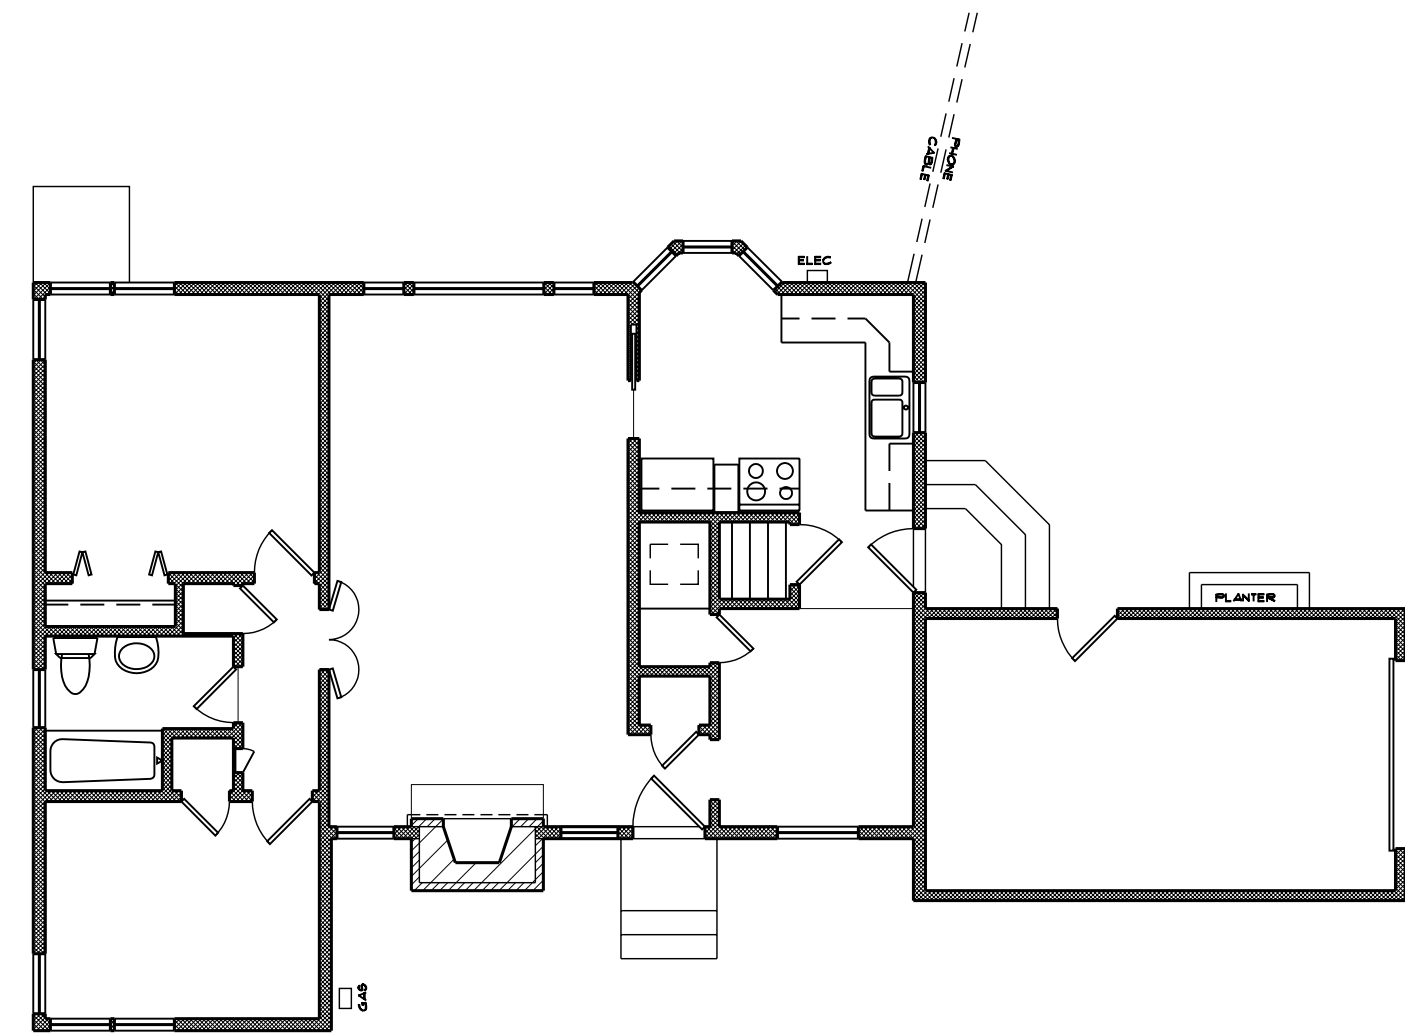


2 MAIN LEVEL DEMO PLAN
1/8" = 1'-0"

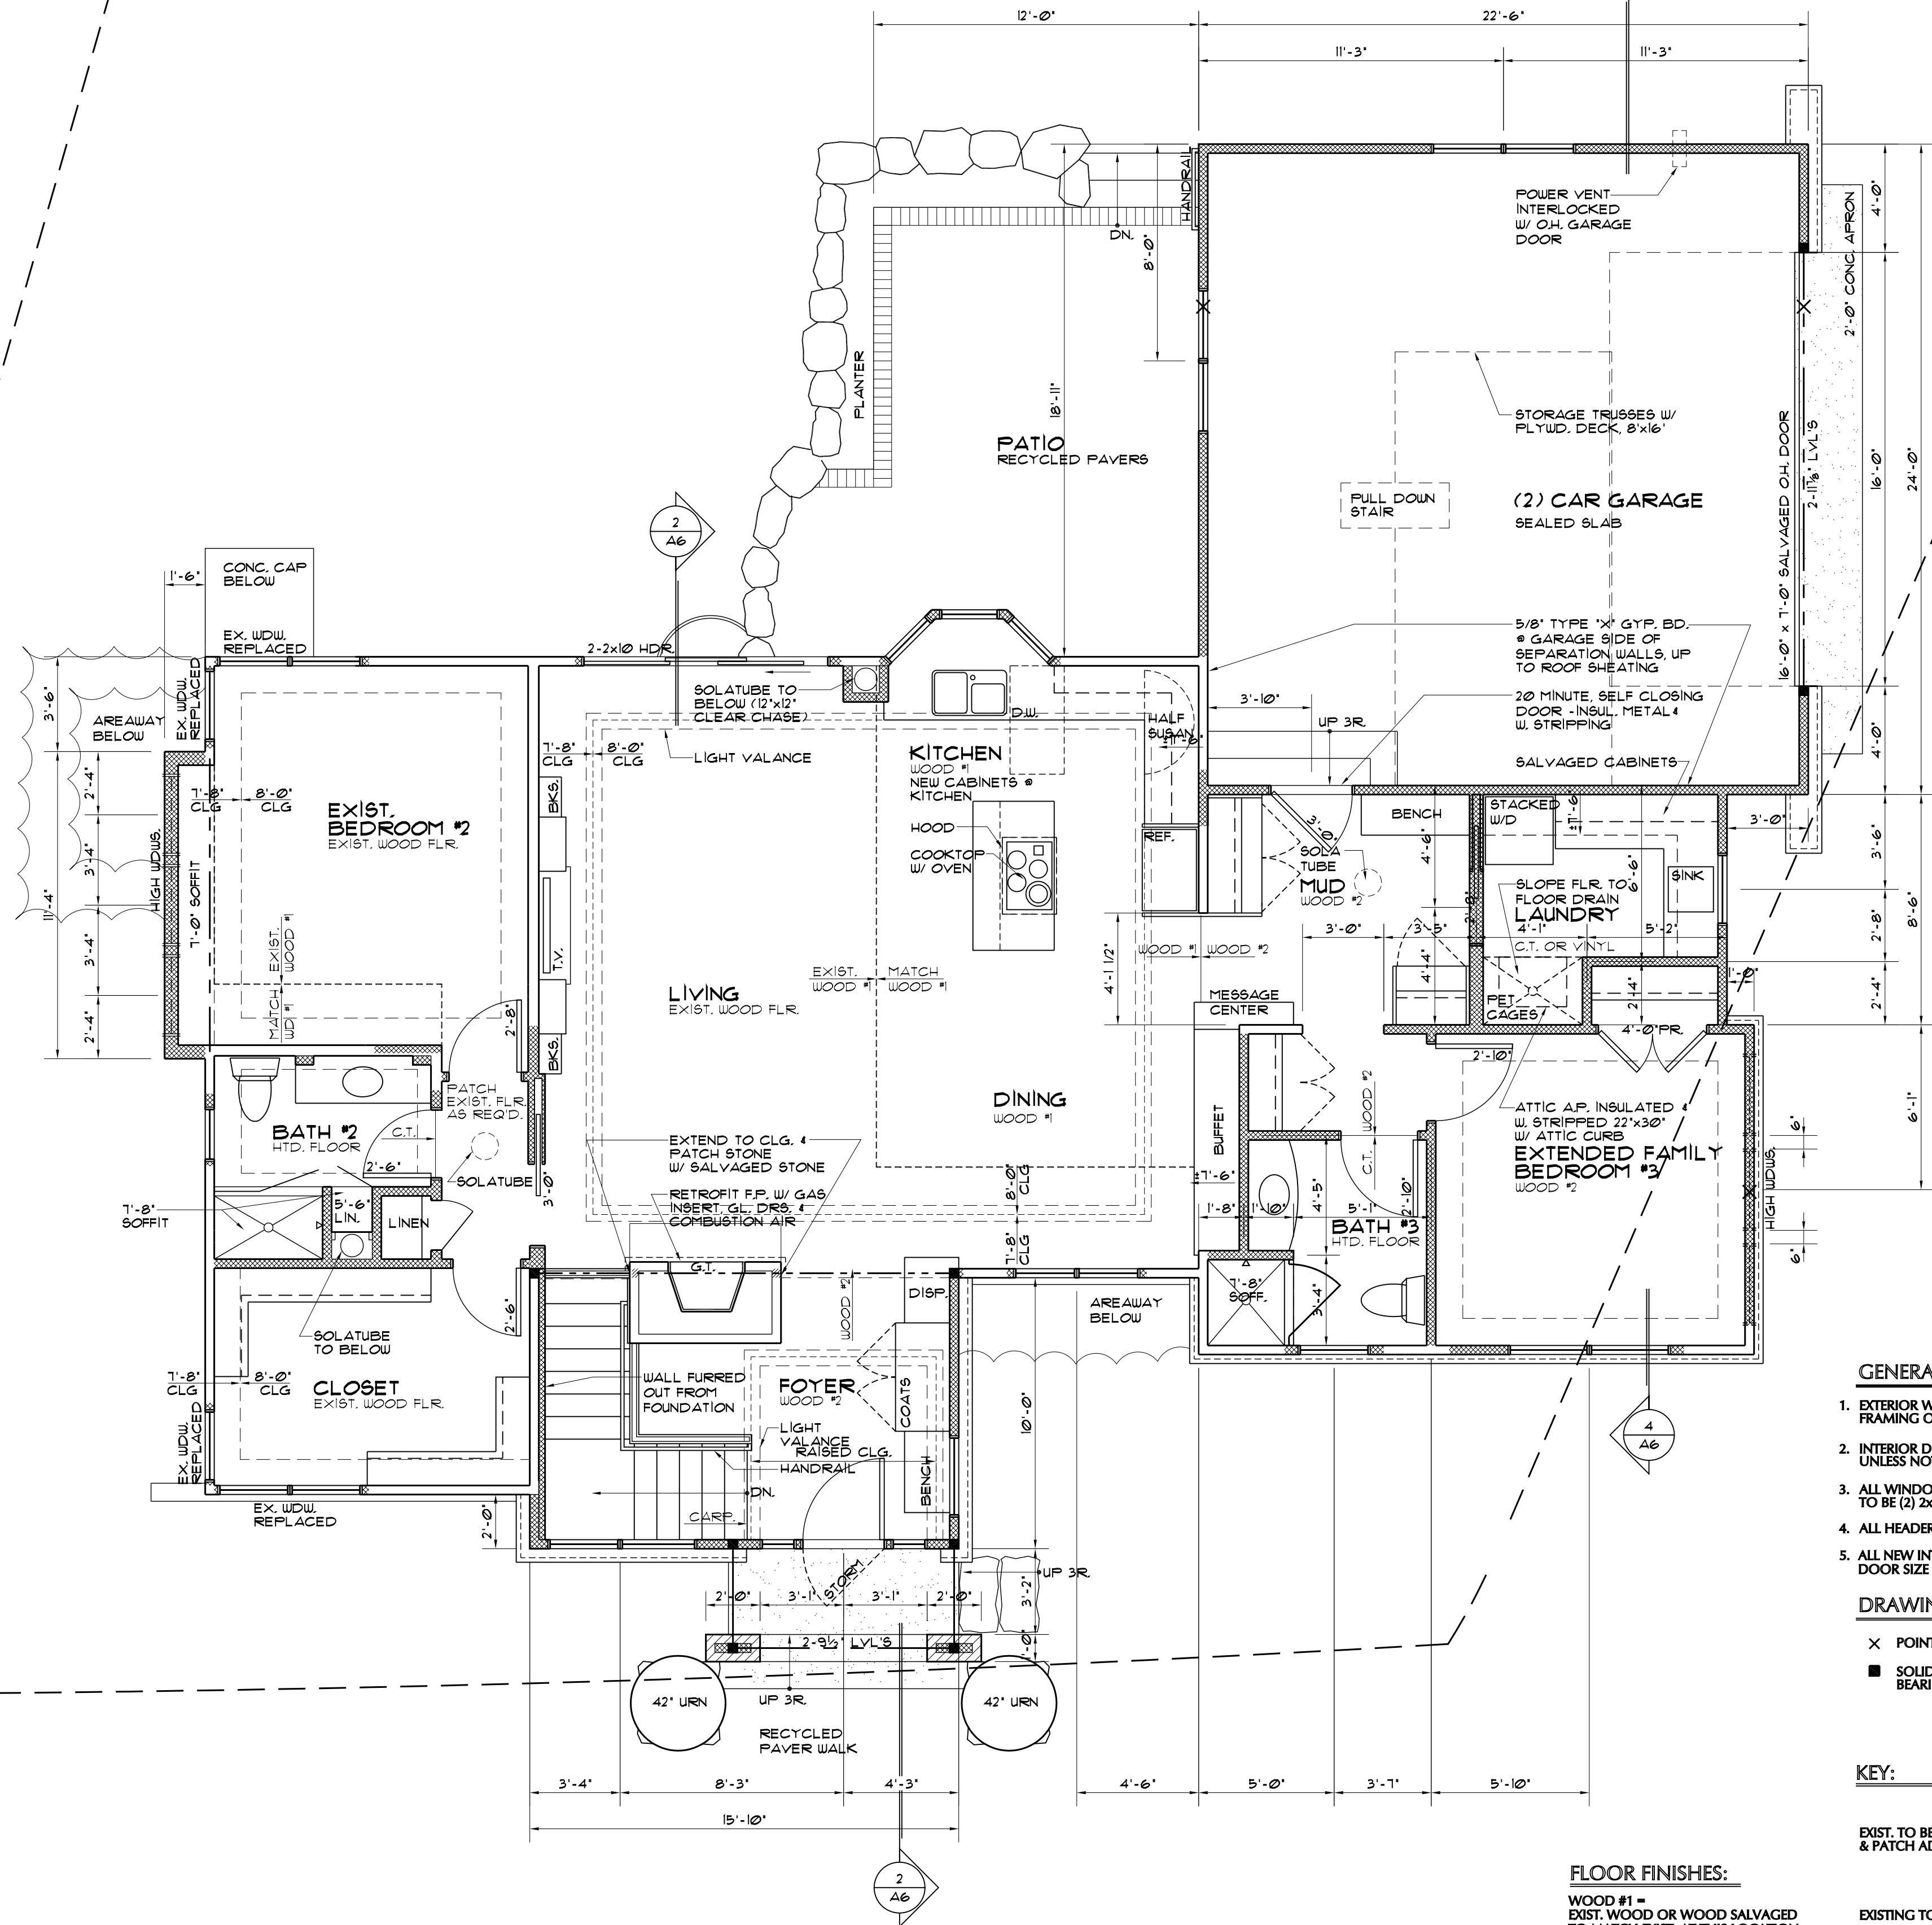

4 MAIN LEVEL ASBUILT
1/8" = 1'-0"

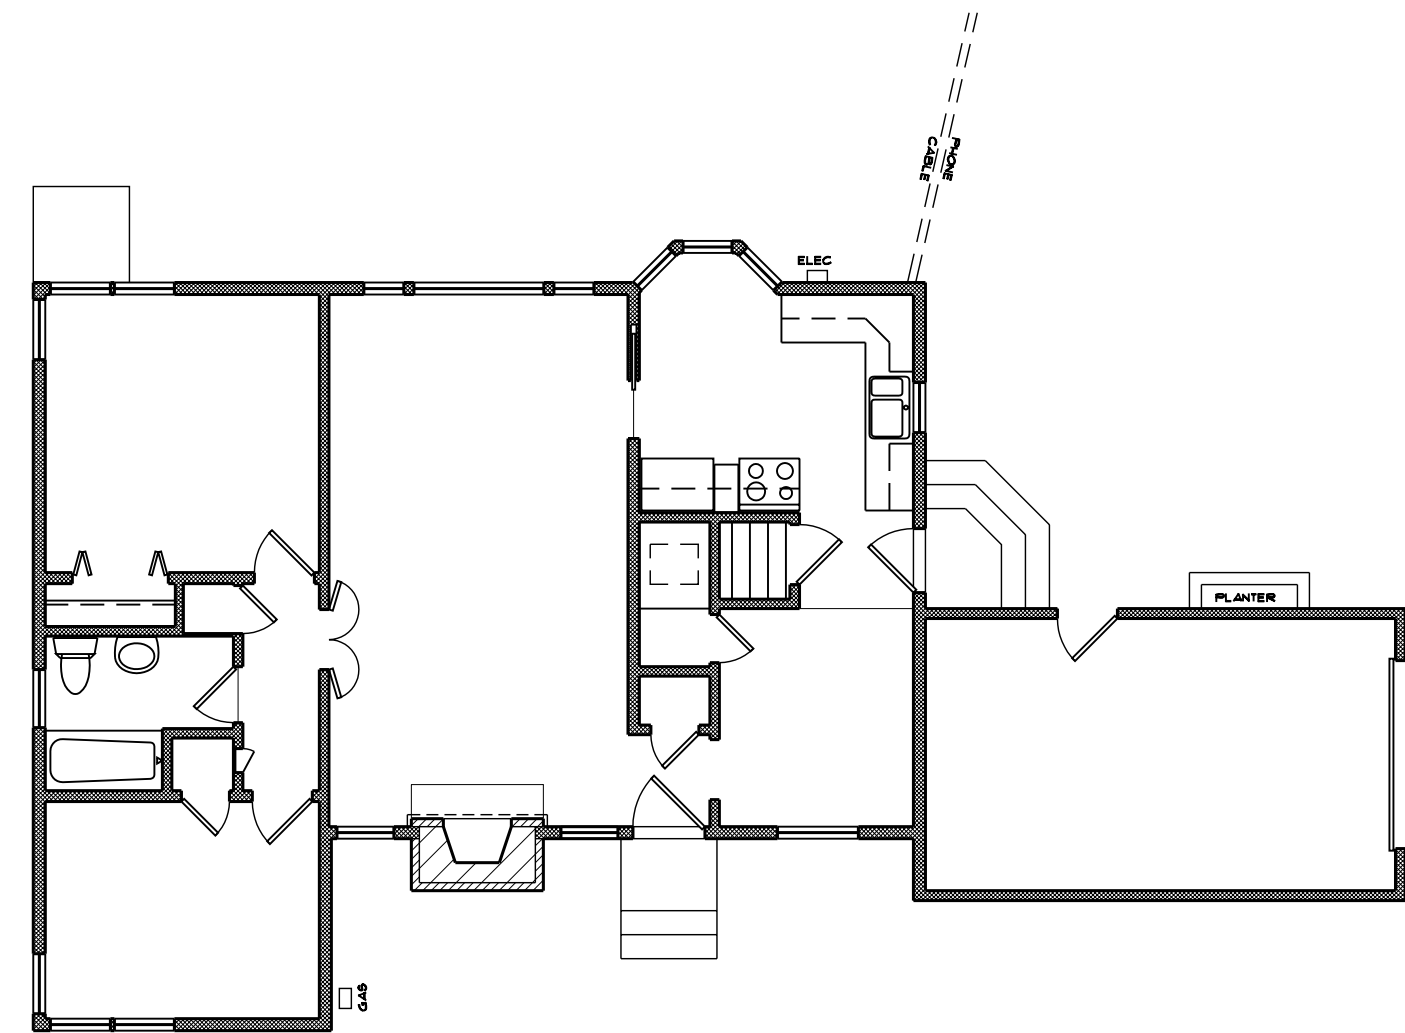

GENERAL NOTES:

- EXTERIOR WALL DIMENSIONS ARE FROM OUTSIDE FACE OF FRAMING OR FOUNDATION.
- INTERIOR DIMENSIONS ARE TO CENTER LINE OF WALL UNLESS NOTED AS "CLEAR".
- ALL WINDOW & DOOR HEADERS @ EXTERIOR & BEARING WALLS TO BE (2) 2x8'S U.N.O.
- ALL HEADERS & BEAMS TO BE DROPPED UNLESS NOTED AS "FLUSH".
- ALL NEW INTERIOR DOORS TO BE SALVAGED DOORS. DOOR SIZE PER PLAN.

DRAWING KEY:

- X POINT LOAD FROM BRG. ABOVE
- SOLID BLOCKING FOR BEARING ABOVE

KEY:

EXIST. TO BE REMOVED & PATCH ADJACENT SURFACES

EXISTING TO REMAIN INFILL TO MATCH

NEW CONSTRUCTION
2x4 EXTERIOR
2x4 INTERIOR U.N.O.
(24" O.C. STUD SPACING)

BUILT-INS ASSUMED FROM SALVAGE SOURCES

REMODELED AREA 968 S.F.
NEW AREAS 575 S.F.
TOTAL (W/O GARAGE) 1543 S.F.

FLOOR FINISHES:

WOOD #1 =
EXIST. WOOD OR WOOD SALVAGED TO MATCH EXIST. AT THIS LOCATION

WOOD #2 =
SALVAGED WOOD OF ANOTHER SPECIES

REFERENCE NORTH



24
A3

MAIN LEVEL
1/4" = 1'-0"

Comm 10/20/00
Date 03/14/07
Drawn CGW, JJW
Checked RM

Revision

MAIN LEVEL

Sheet No.

A3